

2-84

A

12-28-64

12-28-64



12-28-64

12-28-64

~~JOHNS-MANVILLE #200 BRAKE LINING PURCHASED~~
~~OR RAYBESTOS-MANHATTAN #451~~

② DESCRIPTION LINING FOR PART NO. 48-801:-
 MOLDED LINING, FLEXIBLE ENOUGH TO FORM AGAINST
 2.30" SHOE RADIUS. .3 MINIMUM COEFFICIENT OF
 FRICTION AGAINST CAST IRON WHEEL. 15 PPSI PRESSURE.

NOTE: CROSSED OUT, CANCELLED, FOR REVISION, 12/28/64
 TABLE & CANCEL NOTE IT, 12/28/64
 DMS-0119-10

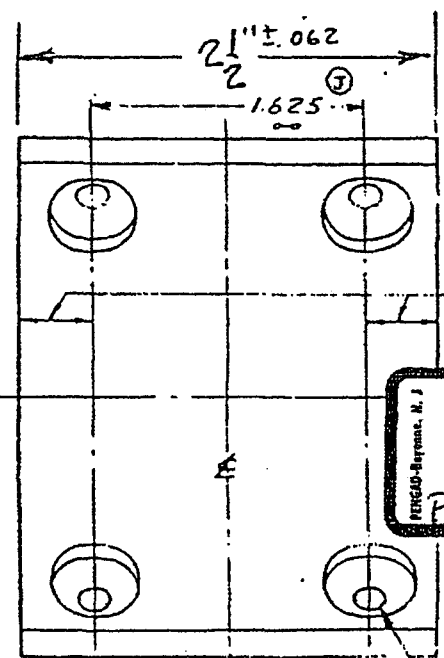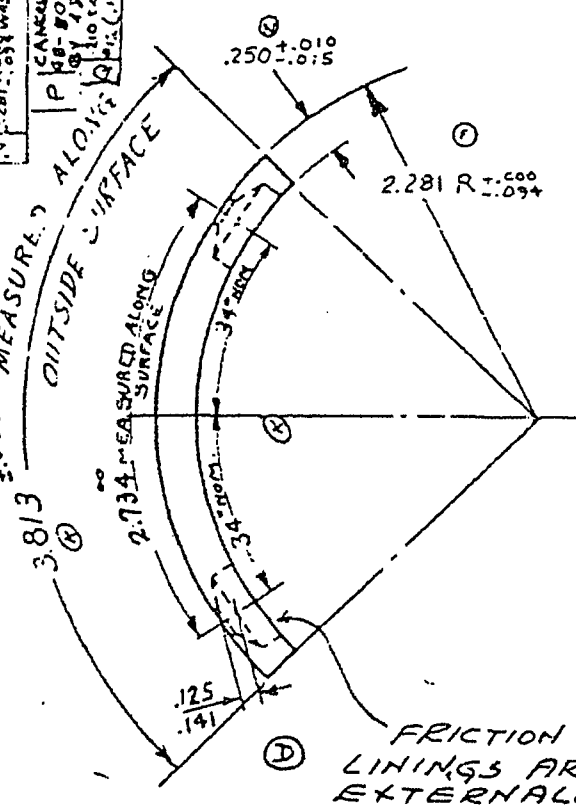

PLAINTIFF'S
 EXHIBIT
 35
 BOMESS
 9-5-63

④ (4) .210 ±.005 DIA.
 8 CTR BORE 130°
 16
 ① FRICTION SIDE.
 LININGS ARE USED
 EXTERNALLY ON WHEEL

NO. REQ	DWG. NO.	PART NO.	QTY	NAME OF PART	CH
1	A	48-1604	1	LINING (MOLDED)	E
1	A	48-338	2	LINING (FOLDED & COMP.)	

NAME: LINING FOR 4" SHOE BRAKE

ORDER NUMBER: DEV. 2806-2

SUPERSEDED: 32723W4

SUPERSEDED: A 48-338

FINISH: B 48-90

ASSEMBLY WHEN FIRST USED: B 48-90

REVISIONS:

REV	DATE	DESCRIPTION	BY	CHKD
A	12/28/64	NOTE ADDED	WJ	WJ
B	12/28/64	PART NO. 48-801 CANCELLED	WJ	WJ
C	12/28/64	ADDED NOTE - RAD. WAS 2" TO INSIDE OF LINING	WJ	WJ

CHECKED BY: C.A. LLOYD

APPROVED BY: H.E. HODGSON

SCALE: 12=12"

CUTLER-HAMMER, INC. MILWAUKEE, WIS. NEW YORK