


BY RWC DATE 7-2-71
CHKD. BY _____ DATE _____

SUBJECT CONVERSION OF
BAUXITE BED S-109
TO DOWNFLOW

SHEET NO. _____ OF _____
JOB NO. _____

S-109
EDC BAUXITE BED

EDC FILTER

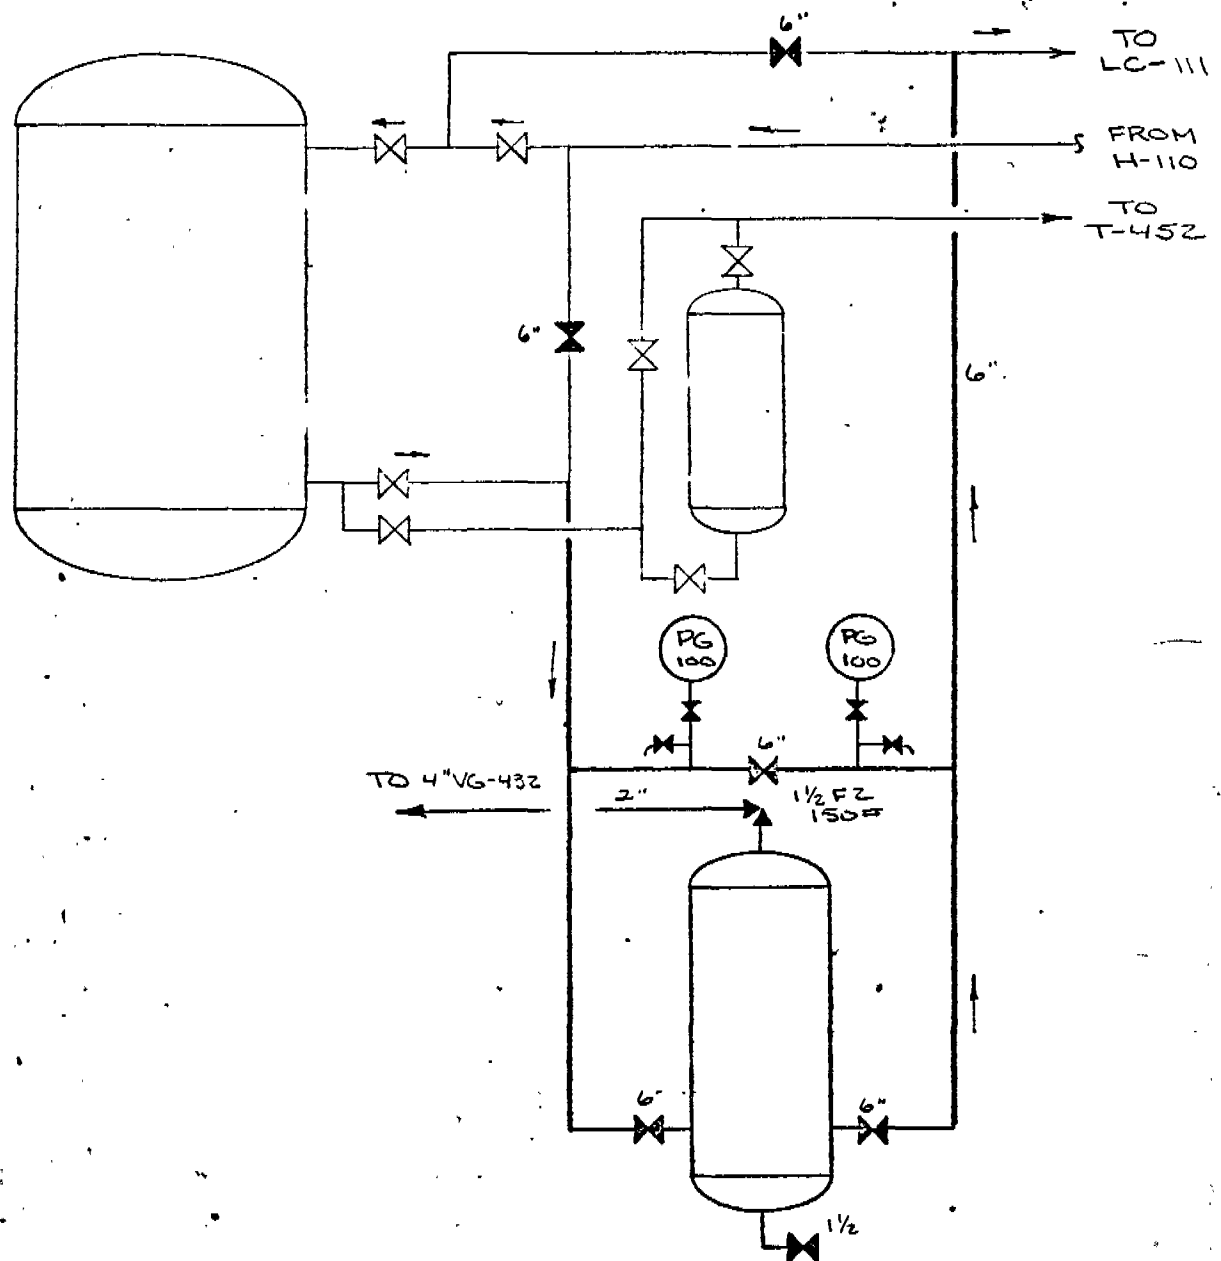

— NEW
— EXISTING

NEW FILTER
FRAM 6SR3 OR EQUAL

(CCR 000041576)


BY RWC DATE 7-2-71
CHKD. BY _____ DATE _____

SUBJECT CONVERSION OF
BAUXITE BED S-109
TO DOWNFLOW

SHEET NO. _____ OF _____
JOB NO. _____

S-109
EDC BAUXITE BED

EDC FILTER

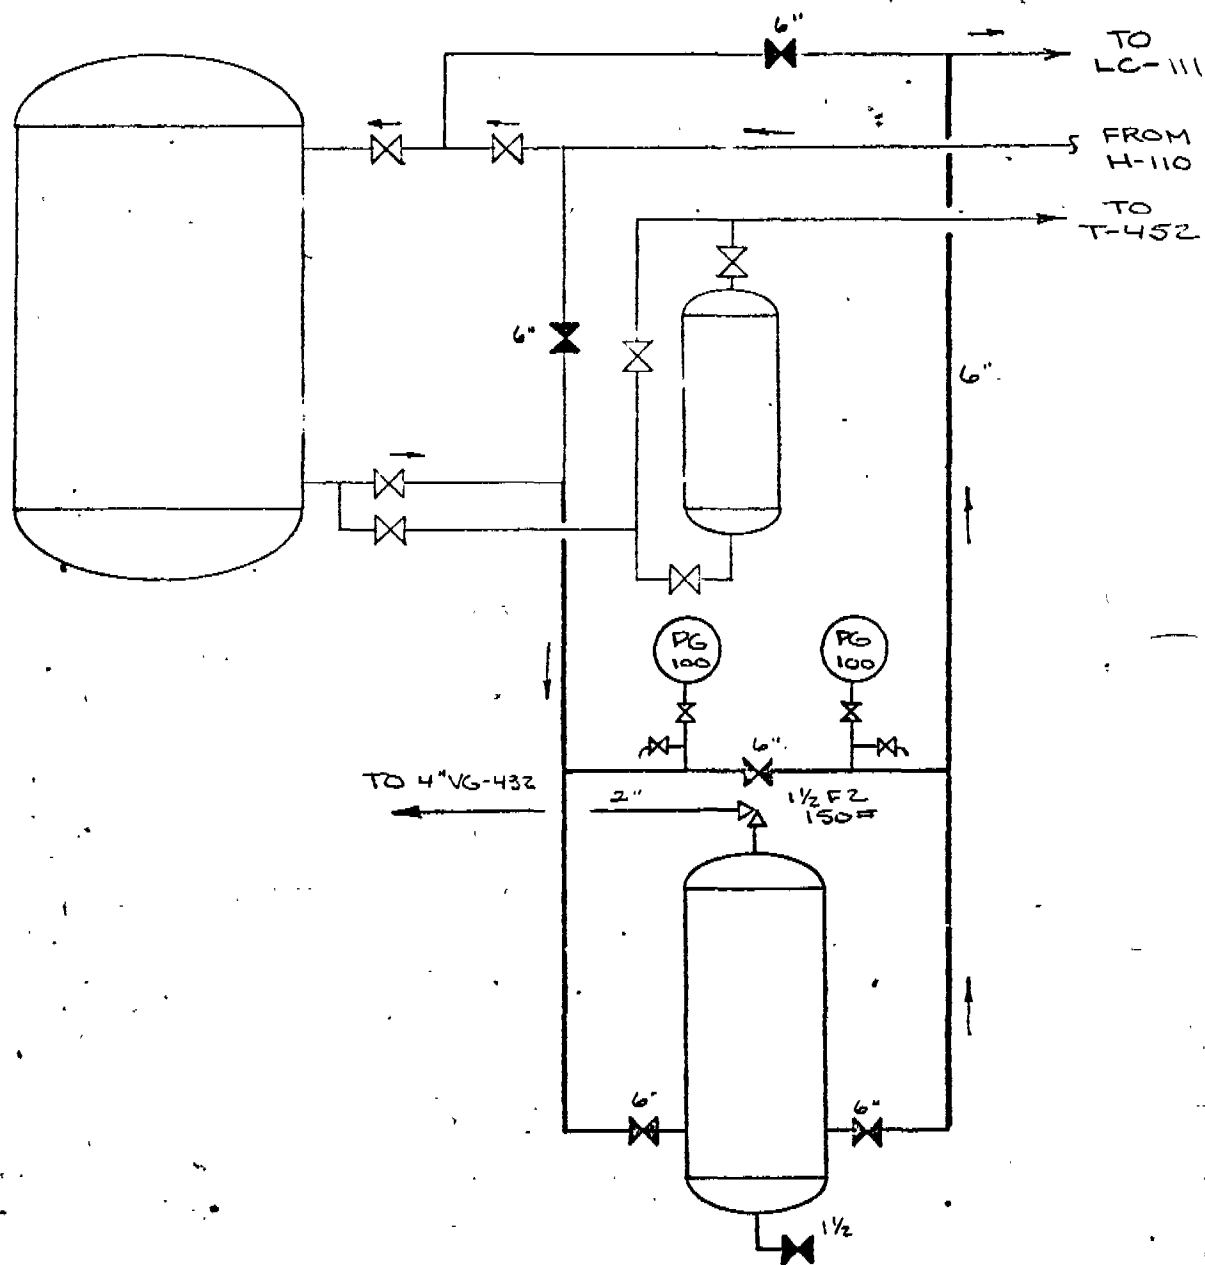

— NEW
— EXISTING

(CCR 000041577

1. 10
2. 2.57

FRAM 65 R3
#137, w/amp

FILTERS, Inc.
4-6 wks

EADS

5-52-4-6F

165 MSN 2 150# ASME code - 8-10 wks
#1310 + 92 + 75 (code)

1.5 psi clear no stamp

immediate shipment

0.5 psi

~~640~~

4/ week 2

+50 for cork stamp

otton 10% + isolated elements

\$3.20 each for 30" el. wire, in 300 lots.

C10AW30T-EC1T

S-35-3-6F

~~\$~~ 775 + 50

S - 52 - 4 - 6F

59 viron 1 wk
1380 + 50

6 wf

S-52-E-6F

$$1220 + 50$$

6. auf.

- 6122

CCR 000041578

250 gwt 1.00

2400

2.1

115 R3

250 psi

1/8 CA

#3630

6 wks.

w/out CA

#3080

65 R3 250 psi

#2900

(CCR 000041580