Monsanto COMPANY

CENTRAL ENGINEERING PURCHASING
800 NORTH LINDBERGH BLVD.
ST. LOUIS, MISSOURI 63166

TRANSMITTAL OF VENDOR DATA

DISTRIBUTION:

J. P. BLANKENSHIP-1
R. S. YATES-1+reprod.
J. G. CLIFTON-2
H. F. RAY-1
M. S. FELD-1
T. A. JACKSON-1
P.O.FILE-T.O.

PROJECT NO. 1800

LOCATION E. ST. LOUIS, ILL

DATE 6/13/68

PURCHASE ORDER NUMBER	VENDOR NAME	CAT.	AREA	EQUIP. NO.	DRAWING NO. AND/OR REFERENCE
1800-9-0138	DURIRON COMPANY	013	02	423.000	DWG: A-13187-A *

* REPRODUCIBLE

MISS MARY READY
CENTRAL ENGINEERING PURCHASING

CE-58 (10-67)

PCB-ARCH-EXT0372212

A13187A

Change No.	Alteration	Date

NOTE: USE S.B. JACKET TO MAINTAIN OPERATING TEMP. - SHAFT MUST TURN FREELY AT START-UP

CUSTOMER COPY

Order No.	1800-9-0138
Project No.	1800PLUG
Area	02
Equipment No.	423.000
Description	Pump (Seal)
Approved by	J P Blankenship
Date	6-11-68
Check Corrections noted	☐ as Shown ☒ Final

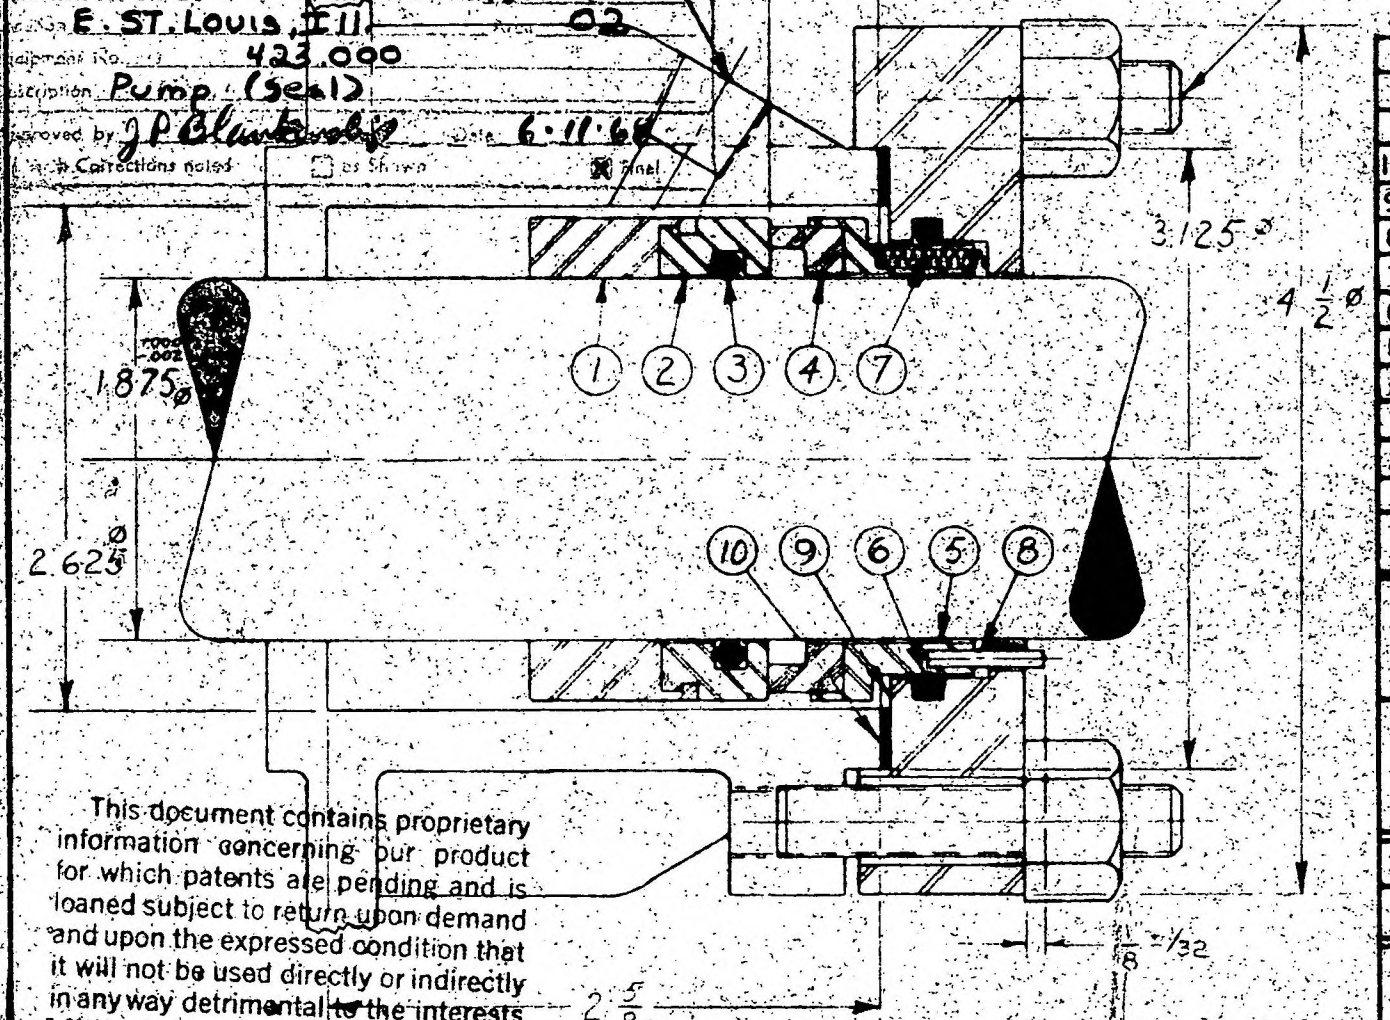

10	GASKET 1/16" thk	2 5/8 x 3 1/8	#260
9	GLAND	S12612A	316SS
8	PIN	3/32 x 5/8	316SS
7	SPRINGS (6)	F - 3	HAST-C
6	DYNAMIC "O" RING	2-228	VITON
5	SEAL RING HOLDER	914C-15	316SS
4	STATIONARY SEAL RING	913C-15	CARBON
3	STATIC "O" RING	2-225	VITON
2	ROTARY SEAL RING	912C-15	316SS/TC
1	LOCK RING ASS'Y	911C-15	316SS
	PART NAME	PT NO	MAT'L

EQUIP DURIRON
MODEL MK II GR II
SERIAL NO.
SHAFT SPEED

SERVICE: BIPHENYL & FERRIC CHLORIDE
OPERATING TEMP 210°F
PRESSURES: DISC SUCT
ST. BOX

CUST MONSANTO CHEMICAL
DIST THE DURIRON COMPANY

CHESTERTON PACKING & SEAL CO
WOBURN, MASS. USA

INSTALLATION 500-C
"COUNTERPOISE" SEAL
1 7/8 SIZE

This document contains proprietary information concerning our product for which patents are pending and is loaned subject to return upon demand and upon the expressed condition that it will not be used directly or indirectly in any way detrimental to the interests of the A. W. Chesterton Co.

* INDICATES INSTALLATION DIMENSION

MATERIAL CODE				
SEAL SIZE	FACE MAT'L	METAL PARTS	'O' RING MAT'L	GLAND MAT'L
15	D	1	W	1

Tolerances, Unless Otherwise Specified ± .010 Frac ± .003 Dec

Date 3-25-68 Scale NONE
Dr. By P.G.S. Ckd. By [illegible]

A13187 A

PCB-ARCH-EXT0372213