
Uncontrolled Copy

AP46733

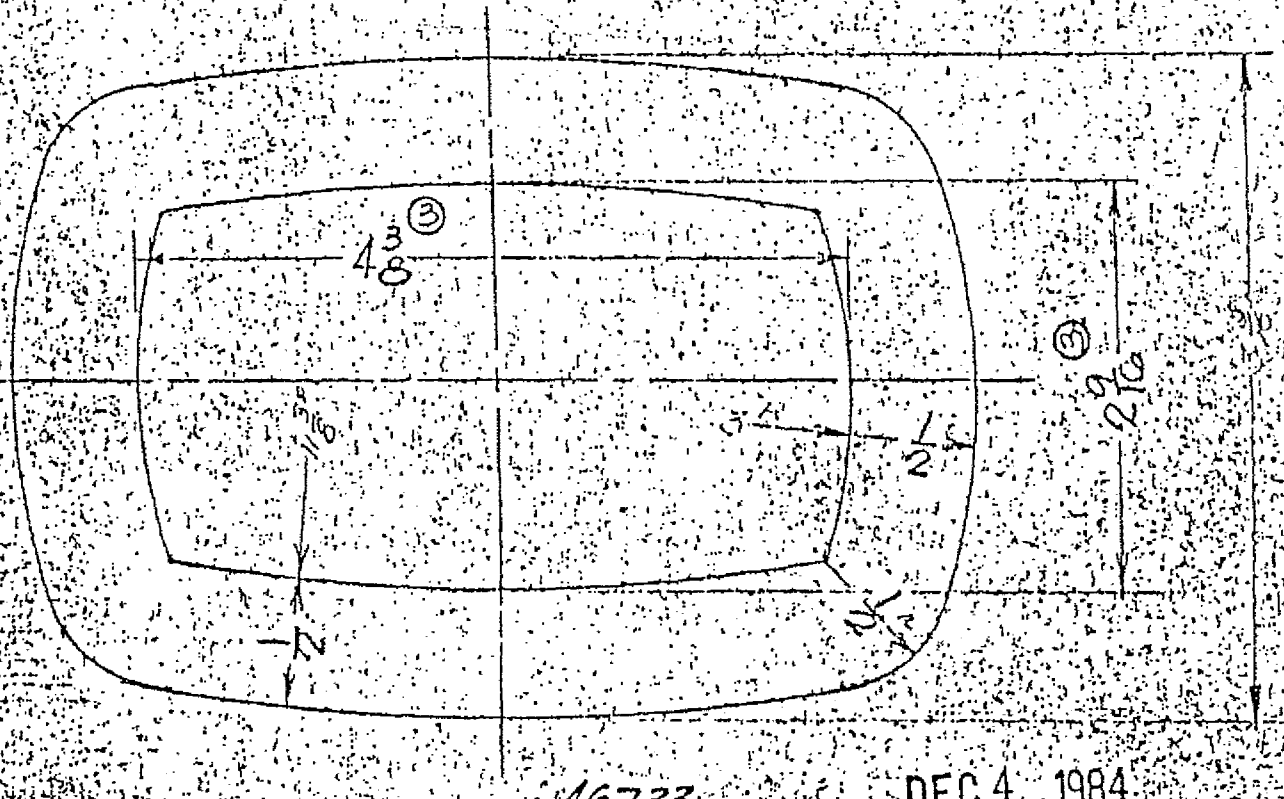

~~DETAIL 1401 SHEET 1~~
~~ROCK # 1021~~
~~MA # 6603~~
~~A # 600 ③④~~
~~ANCHOR # 428~~

46733
PART NO. ~~40665~~

DEC 4 1984

USED ON:
607-617- 2½"

2½ F619 BODY GASKET

46733

NIBCO of Canada
A Division of NIBCO

DETAIL SCALE

NO.	REVISIONS
1	WAS 501
2	WAS # 660
3	WAS 4" 2 3/16
4	WAS 2-NO OTHER

MAKE-TAN

NIBCO001569

DATE	NO.	REVISIONS				
		REDESIGNED & REDRAWN WAS SHOWN ON AP-40686	DATED 9/11/67	1-25-71	1	WAS 23a, 23b & 23c FED. S.P.

MATL: HIGH TECH CARLOCK

#7021, RAM #6063, U-MATSO

ASNCLEOR #4425

Uncontrolled Copy

USED ON:

607-617-311

DEC 4 1984

1. DO NOT SCALE.
2. BREAK ALL CORNERS UNLESS OTHERWISE SPECIFIED.
3. TOLERANCES UNLESS OTHERWISE SPECIFIED
FRACTIONAL DIMENSIONS ± 1/64
DECIMAL DIMENSIONS ± .010

NTBCO
INC.
ELKHART, INDIANA

619-311 BODY GASKET

PART No. 406867344

Drawn by: ESCALL	Chk'd. by:	Scale: FULL
Apprvd:		DWG. NO: AP-406867344
DATE: 11-14-67		

NIBCO001570

DATE NO. REVISIONS BY REASON
DATE NO. REVISIONS BY REASON
Uncontrolled Copy
DEC 4 1984
T 16

NIBCO001572

DATE	NO.	REVISIONS	DATE	NO.	REVISIONS
		REDRAWN FROM AP-424-76			

MATERIAL
.120 SHEET
FOR LOCK-BEAD
EXTRUSION

FINISH SIZE
2269 2 1/2
6267 2 1/2

BODY GASKET, INC.
ELKHART, INDIANA

PART NO. TO 424784 6737

DRAWN APPROVED

SCALE FULL

UNCONTROLLED COPY

DEC 4 1984

DO NOT SCALE DRAWING
REMOVE ALL BURRS AND SHARP EDGES
UNLESS OTHERWISE SPECIFIED
TOLERANCES UNLESS OTHERWISE SPECIFIED
FRACTIONAL ±1/64
DECIMAL 2 PLACE ±.03
3 PLACE ±.010
ANGULAR ±1°

NIBCO001573

DATE	NO	REVISIONS	DATE	NO	REVISIONS	DATE	NO	REVISIONS
		REDRAWN - WAS						
		CL BD. 62508						
		DATED 5-8-85						
		(HERRIGER) TAN						

MATL: 1/16 THICK SHEET
GARLOCK #3924
RING #6002
TAPE #59
ANCHOR #4128

USED-ON
607-617-1211
669-1011
669-1211

Uncontrolled Copy
DEC 4 1984

NORTHERN INDIANA BRASS CO.
ELKHART, INDIANA
619-1211 STUFFING BOX GASKET
PART No. 4250-8 & 4267-8


Drawn by: GSEACCY
Chk'd by:
Approved:
DATE:

5 1/16
4 1/8

NIBCO001574

BP46753

NIBCO001575

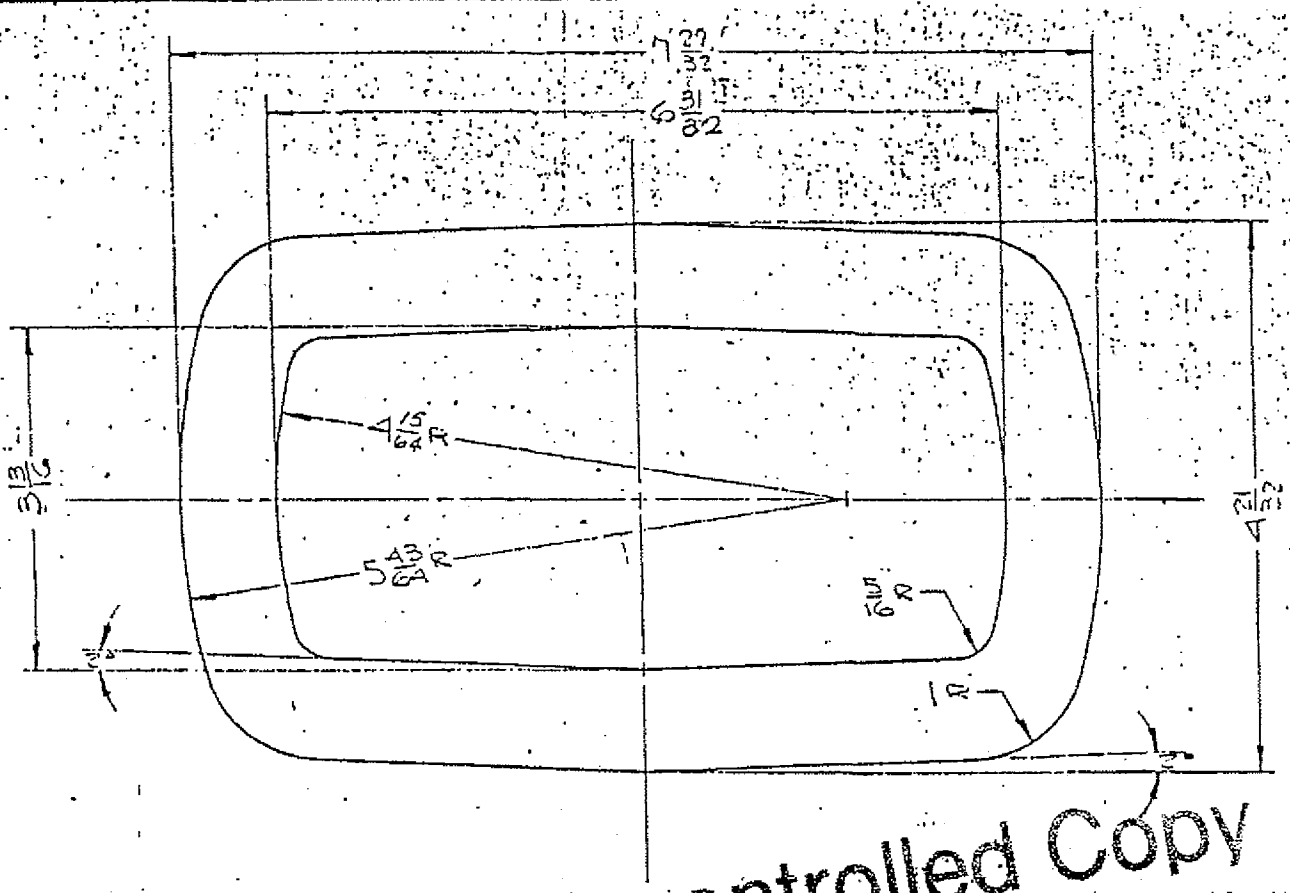

Uncontrolled Copy

DEC 4 1984

NO.	DATE	REVISIONS	BY	CHK'D
1	12-15-61	ORIGINAL DRAWING		
2	1-5-62	CHANGED MATERIAL		
3	1-8-62	CHANGED MATERIAL		
4	1-15-62	CHANGED MATERIAL		

MAT'L - 1 THICK [illegible]
GARLOCK #[illegible]
R/M #665
[illegible] #50
ALCO #485

USED ON:
(617-607) - 5"

1. DO NOT SCALE.
2. BREAK ALL CORNERS UNLESS OTHERWISE SPECIFIED.
3. TOLERANCE UNLESS OTHERWISE SPECIFIED:
FRACTIONAL DIMENSIONS ± 1/64
DECIMAL DIMENSIONS ± SHOWN

NIBCO
INC.
ELKHART, INDIANA


619-5" ECCY GASKET

PART Nº: [illegible]

Drawn by: [illegible]	Ckd'd by: [illegible]
Approved:	Scale: FULL
DATE: 12-15-61	DWG. NO. BP-[illegible]

[illegible]

BP 46754

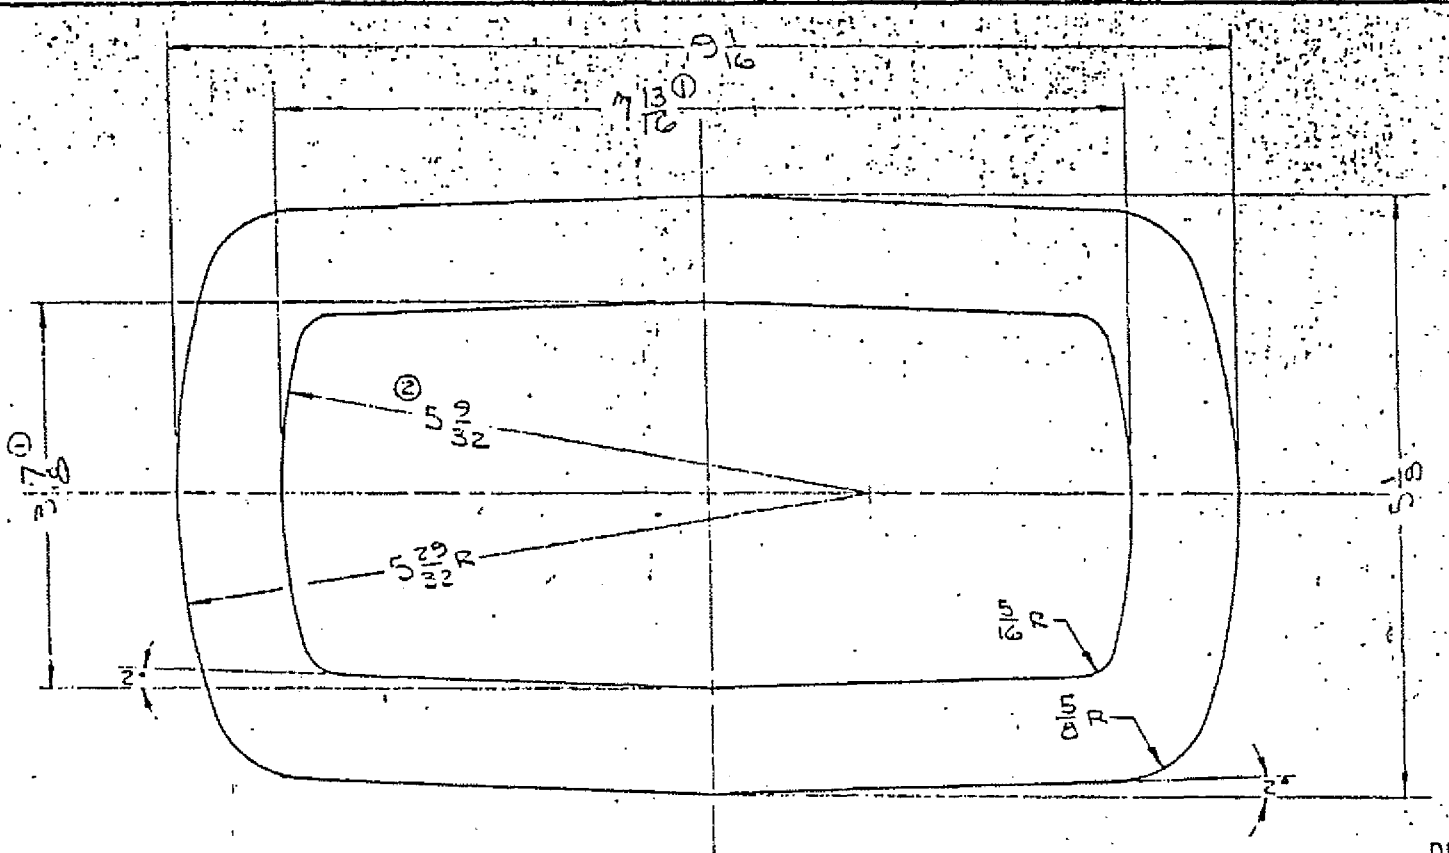

Uncontrolled Copy

DEC 4 1984

1. DO NOT SCALE.
2. BREAK ALL CORNERS UNLESS OTHERWISE SPECIFIED.
3. TOLERANCE UNLESS OTHERWISE SPECIFIED:
FRACTIONAL DIMENSIONS ± 1/64
DECIMAL DIMENSIONS ±

MAT'L - ~~1/2 THICK~~
GARLOCK #7029
~~BUNA #6613~~
~~J-M #660~~
ANCHOR #485

USED ON:
609-6"
617(607)-6"

NIBCO INC.
ELKHART, INDIANA

619-6" BODY GASKET
PART NO: ~~AE600~~ 46754

Drawn by: T.E.GALE | Ck'd. by:
Approved: | Scale: FULL 46754
DATE: 11-14-61 | DWG. NO. BP-~~40536~~


NIBCO001576

Uncontrolled Copy
BP 46755
NIBCO001577


BP 467507

Uncontrolled Copy

NIBCO001578

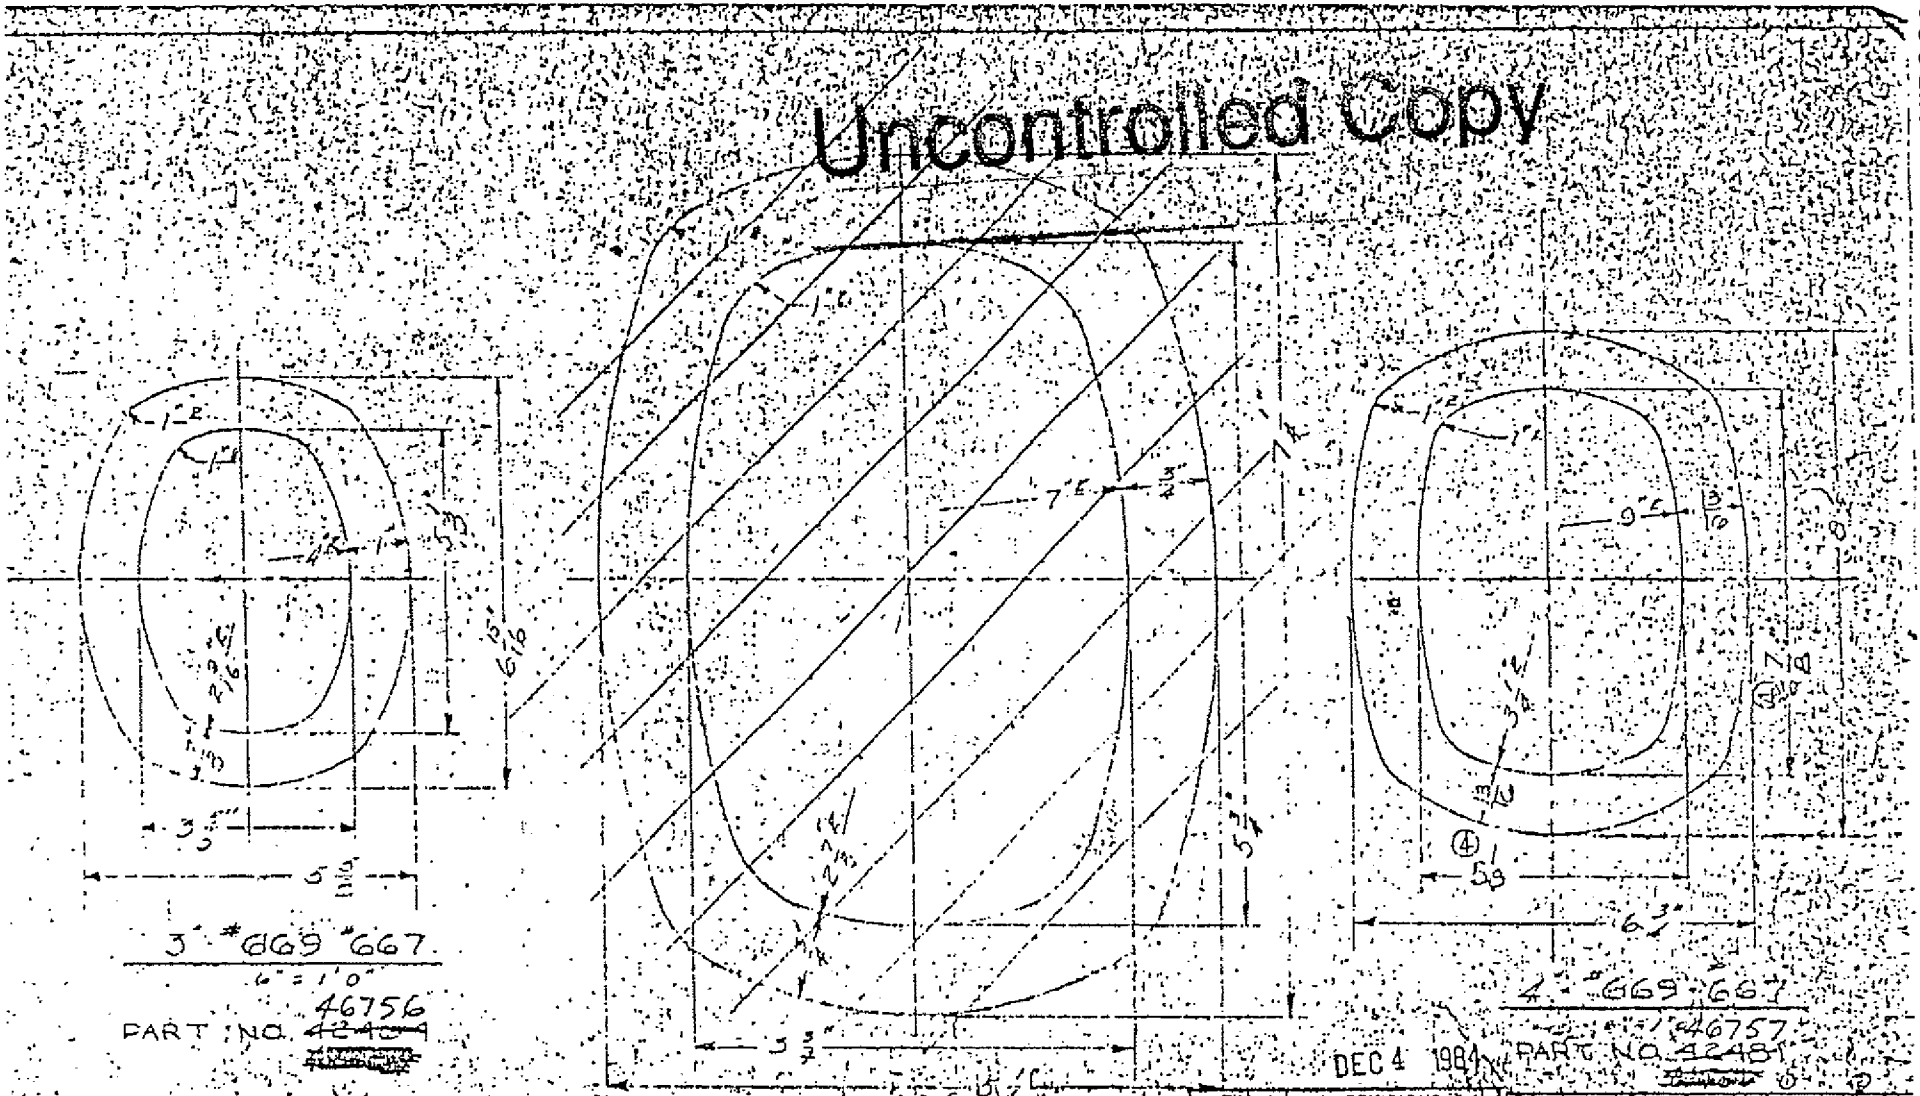

BR 46758

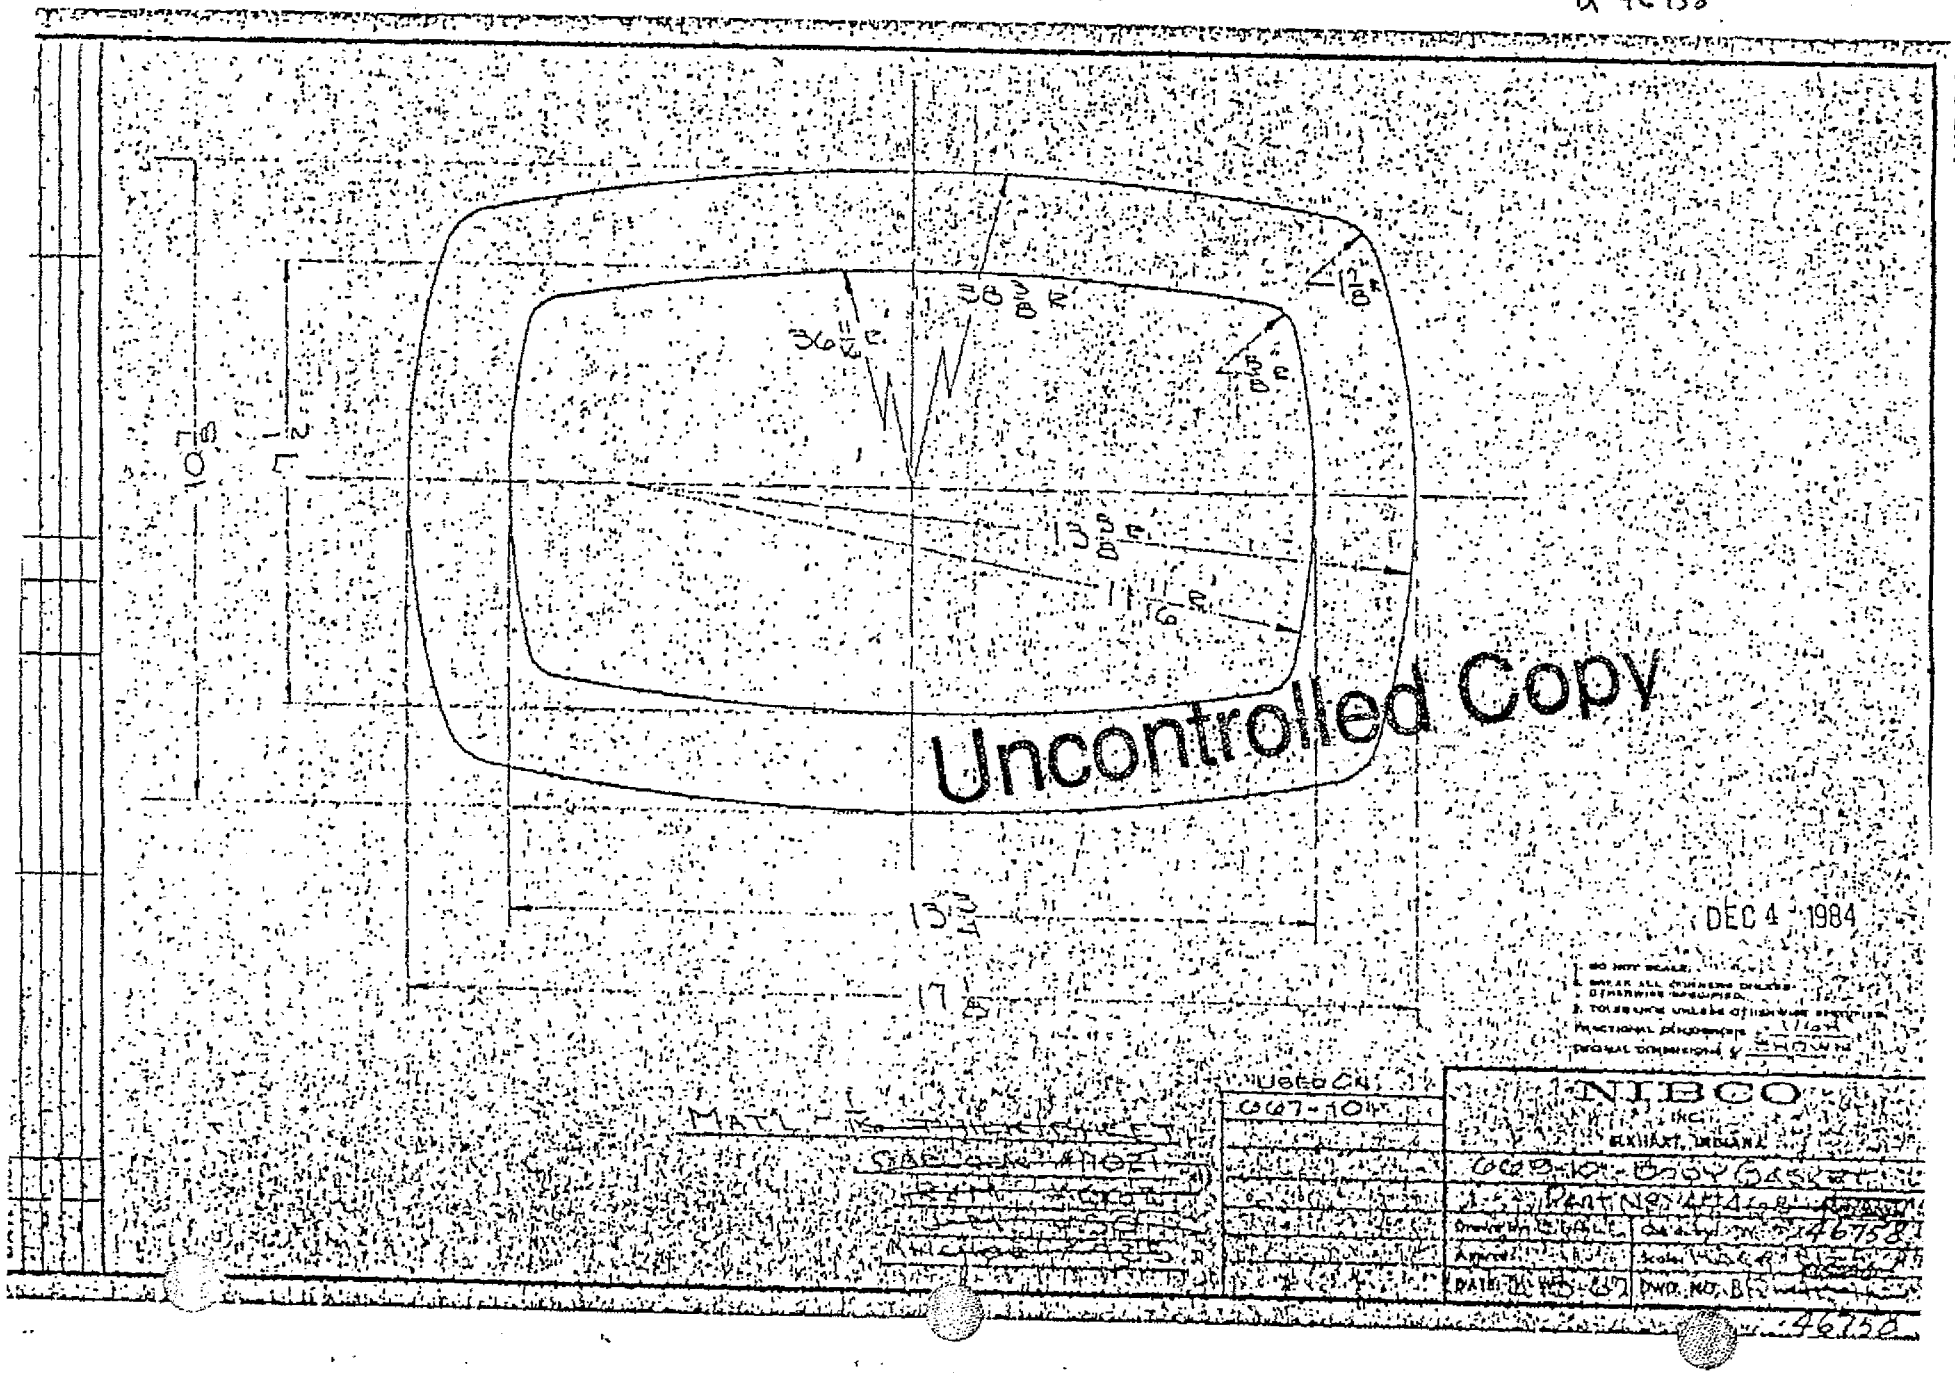


NIBCO001579

BP 46761

Uncontrolled Copy

NIBCO001580

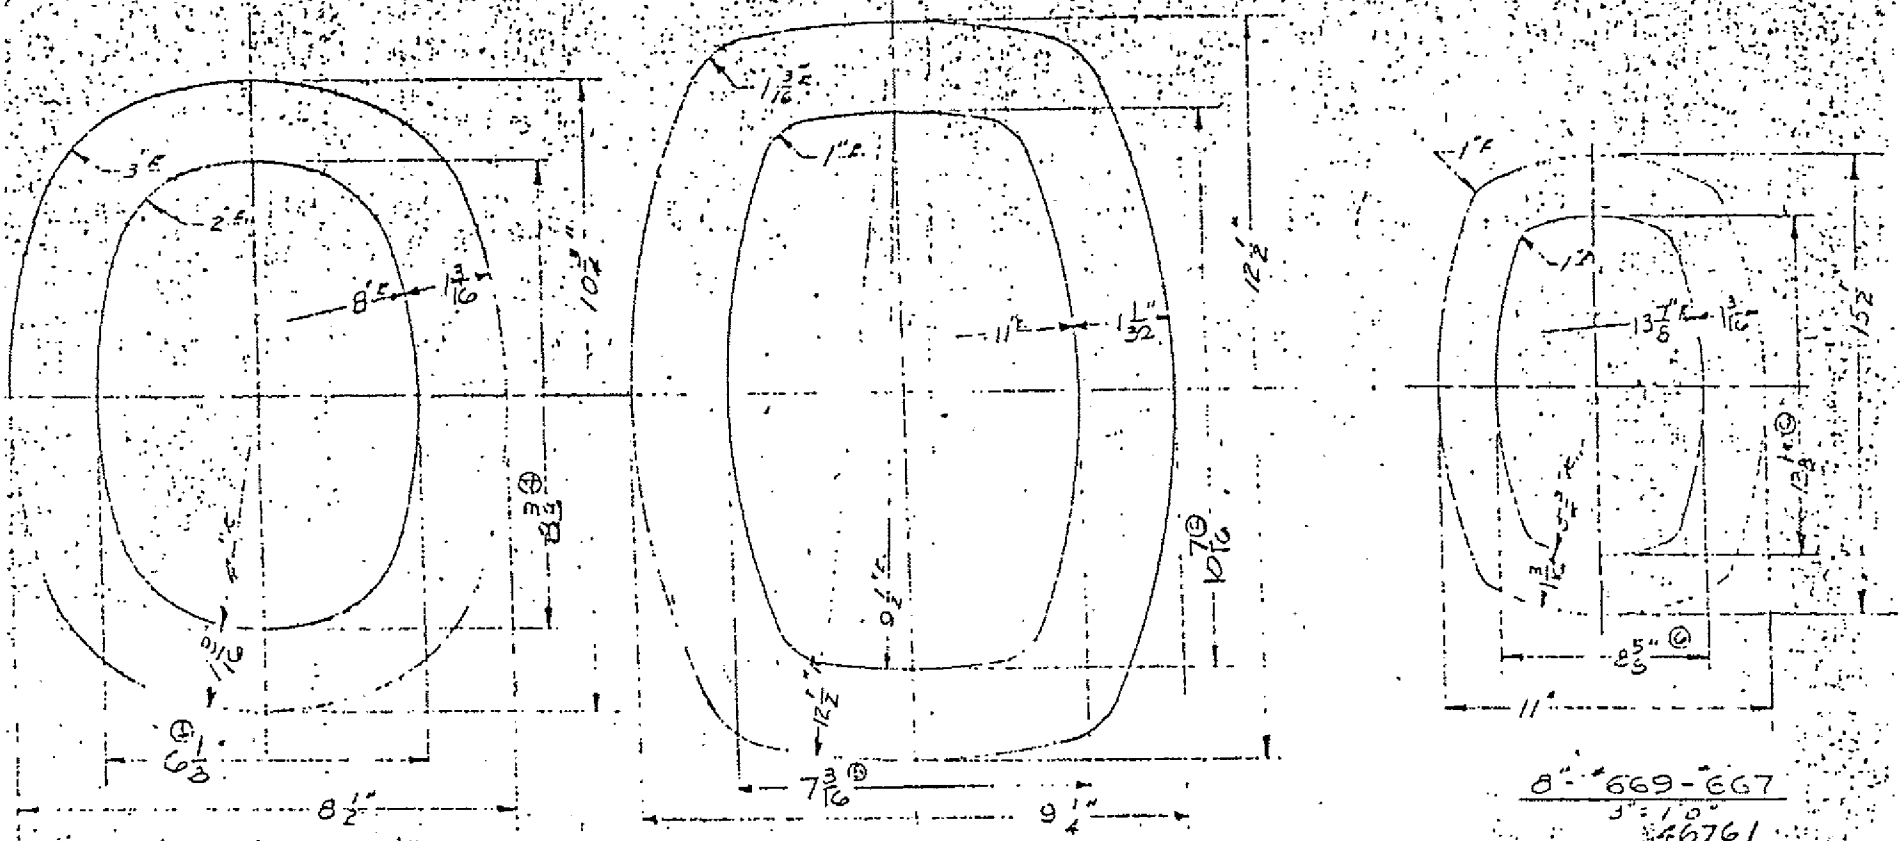

5"-669-667
6"=1'0"
PART NO. 46759

6"-669-667
6"=1'0"
PART NO. 46760

8"-669-667
3"=1'0"
PART NO. 46761

DEC 4 1984

MATERIAL:
HIG SHEET
GARLOCK #7021
R/M # 665
SM # 50

DATE	NO.	REVISIONS
6-9-66	1	WAS 2 1/2
	2	2 3/8
7-15-66	3	1320 7022
2-6-68	4	WAS 3/4 60
1-20-71	5	WAS 5 1/2, 8 1/8
1-26-71	6	WAS 6, 9 1/2
1-28-71	7	WAS 7, 11 1/2


5-6-8" FG69-FG67
GASKETS

NIBCO of Arkansas
Division of NIBCO Inc.

7-11-56

BP46762

Uncontrolled Copy

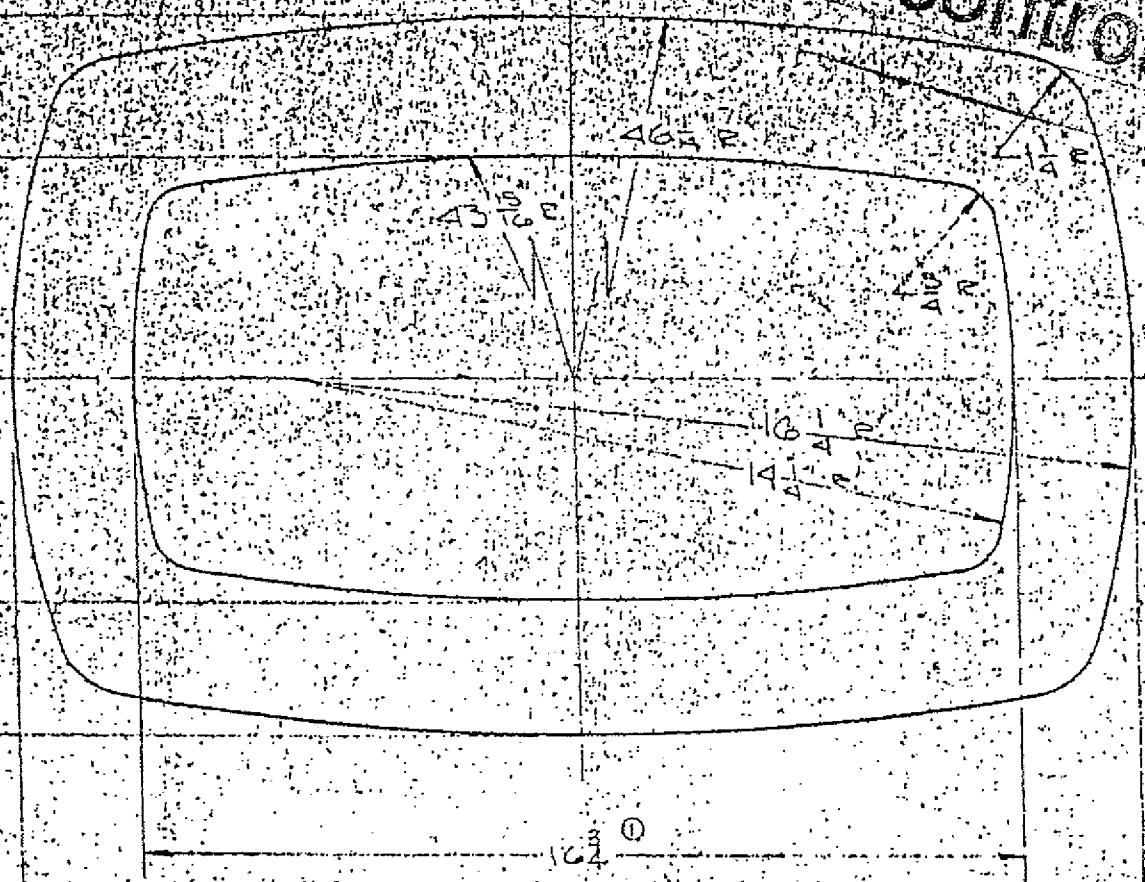

46762
PT. NR

DEC 4 1984

1. DO NOT SCALE.
2. BREAK ALL CORNERS UNLESS OTHERWISE SPECIFIED.
3. TOLERANCE UNLESS OTHERWISE SPECIFIED:
FRACTIONAL DIMENSIONS ± 1/64
DECIMAL DIMENSIONS ± .010


MATL. 1" THK
GAP LOCK #7674
RAT #6603
FLAT #E0
ANCHOR #423

NIBCO INC. ELKHART, INDIANA	
BODY-GASKET	
FIG. NO. 6603	12"
Drawn by: R.E.N.E.	Ck'd. by:
Approved:	Scale: HALF
DATE: 5-20-61	DWG. NO. BP-46762

DATE JNY 1-30-71 MAS 73 15

NIBCO0001581

CB 46763

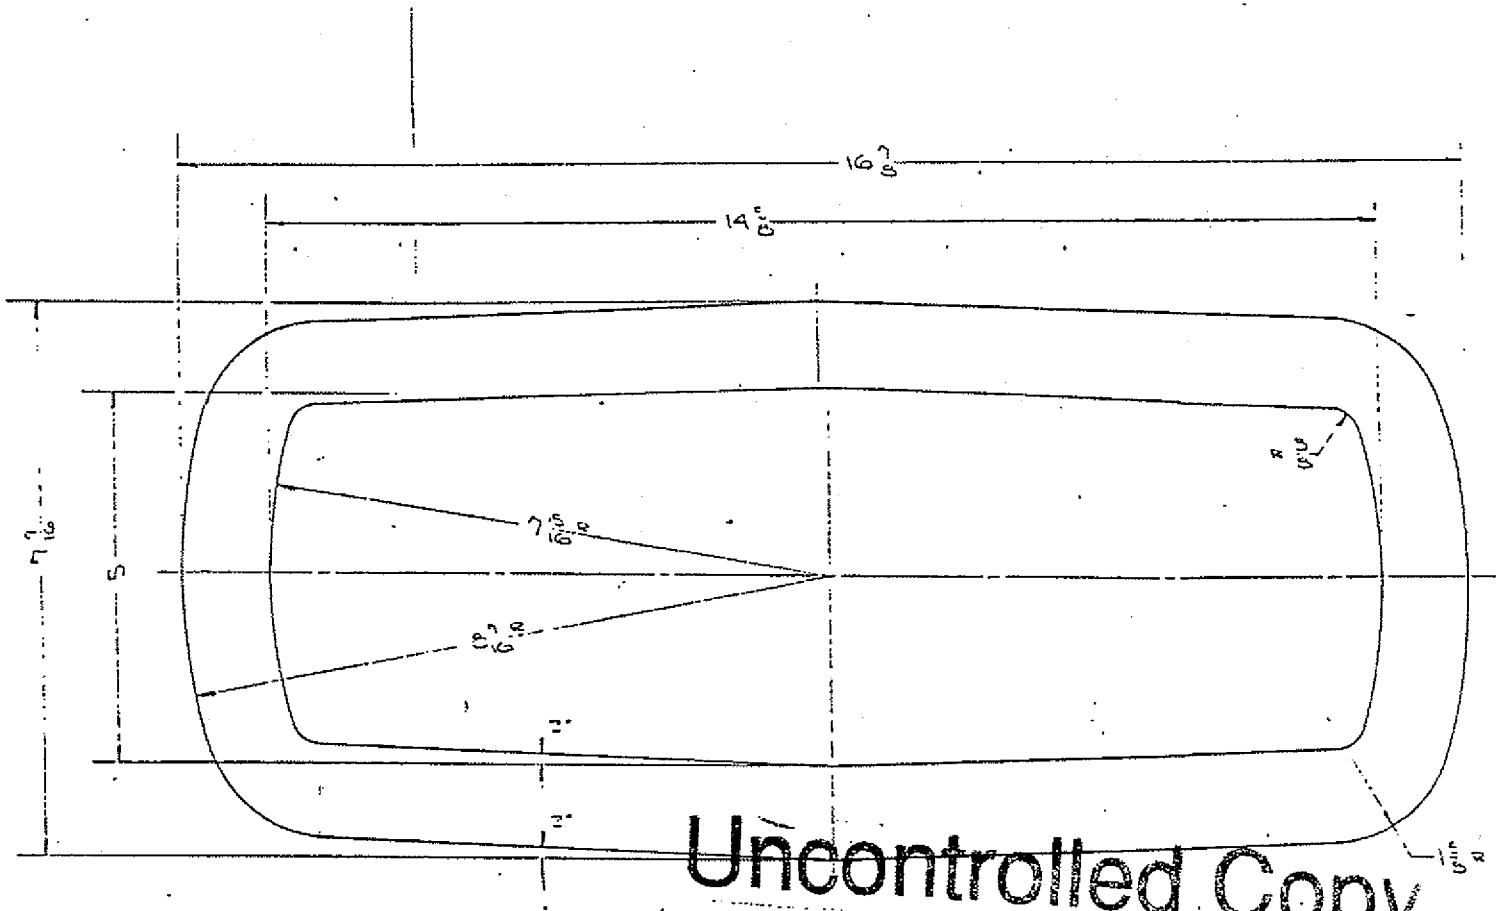

Uncontrolled Copy


MATL. - 1/16 THICK SHEET
G-7BLOCK #7021
2/M #6062
1-M #810
ANCHOR #470

USED ON:
417(227)-1/2"

NIBCO INC.
ELKHART, INDIANA
46762
GIB-1/2" RUBBER GASKET
PART NO. 4-227

NIBCO001582

CP46764

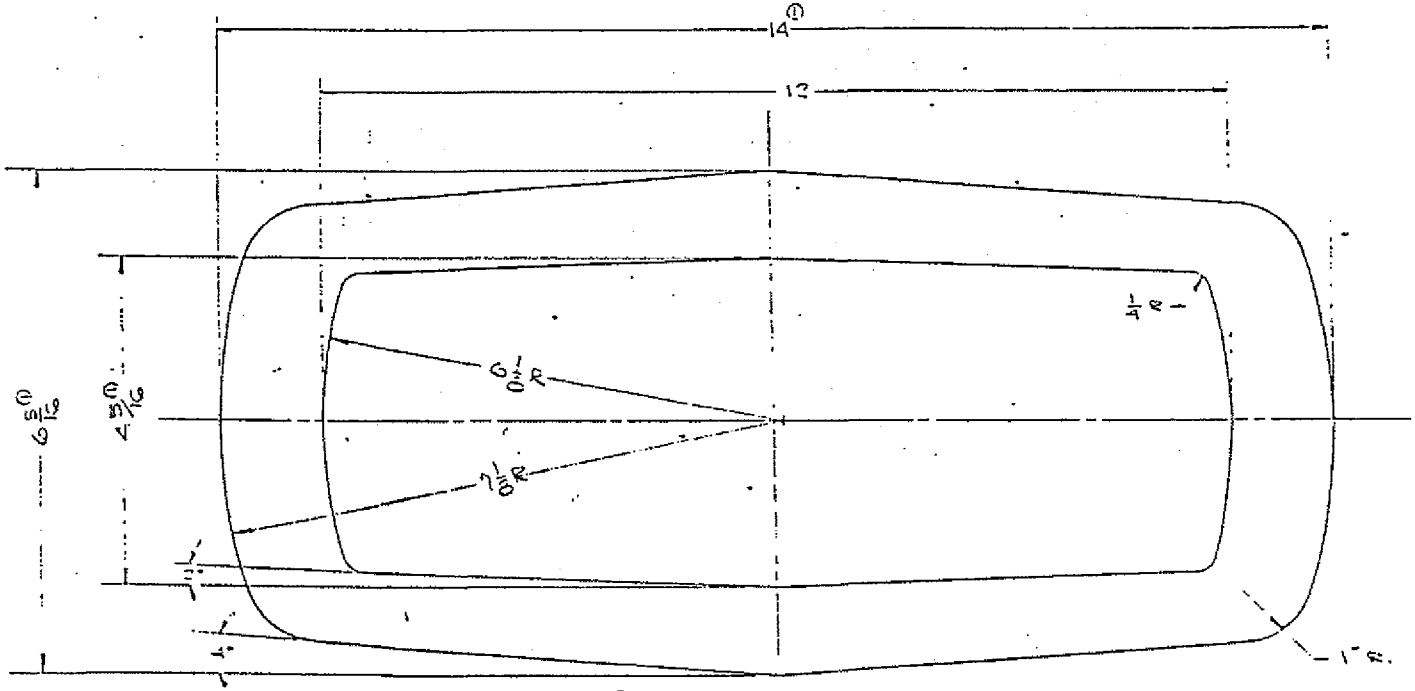

Uncontrolled Copy

MATL - 1/16 THICK SHEET
CARLOCK #1031
E/M #6623
L-M #50
ANCHOR #835

Used On:
617.0271-10*

NIBCO INC. ELKHART, INDIANA
6 1/2-10" BODY GASKET
PATTERN
Drawn by: Chkd by:
Approved: Scale: FULL
Date: Dwg No CP-1764

NIBCO0001583